


NOTES


- 1) MESH FABRICATED OVERSIZE TO INSURE SNUG FIT.
- 2) STANDARD RESISTANCE WELDED CONSTRUCTION.
- 3) YORKMESH® STYLE : 431
- 4) RIGID WELDED AND FULLY BANDED
- 5) MESH SECURED WITH TIEWIRE FURNISHED WITH UNIT
- 6) ALL DIMENSIONS IN MM.
- 7) INSTALLATION FROM BOTTOM
- 8) DEMISTER: 1 REQUIRED

MATERIAL LIST (IN KOY SCOPE OF SUPPLY)



POS NR.	DESCRIPTION	MATERIAL (MESH-GRID)	QTY	SPARES	REMARKS
A001	DEMISTER SECTION	304L	1	-	-
A002	DEMISTER SECTION	304L	1	-	-
A003	DEMISTER SECTION	304L	1	-	-
A004	DEMISTER SECTION	304L	1	-	-
A005	DEMISTER SECTION	304L	1	-	-
A006	DEMISTER SECTION	304L	1	-	-
A007	DEMISTER SECTION	304L	1	-	-
A008	DEMISTER SECTION	304L	1	-	-
A009	DEMISTER SECTION	304L	1	-	-
A010	DEMISTER SECTION	304L	1	-	-
A011	DEMISTER SECTION	304L	1	-	-
A012	DEMISTER SECTION	304L	1	-	-

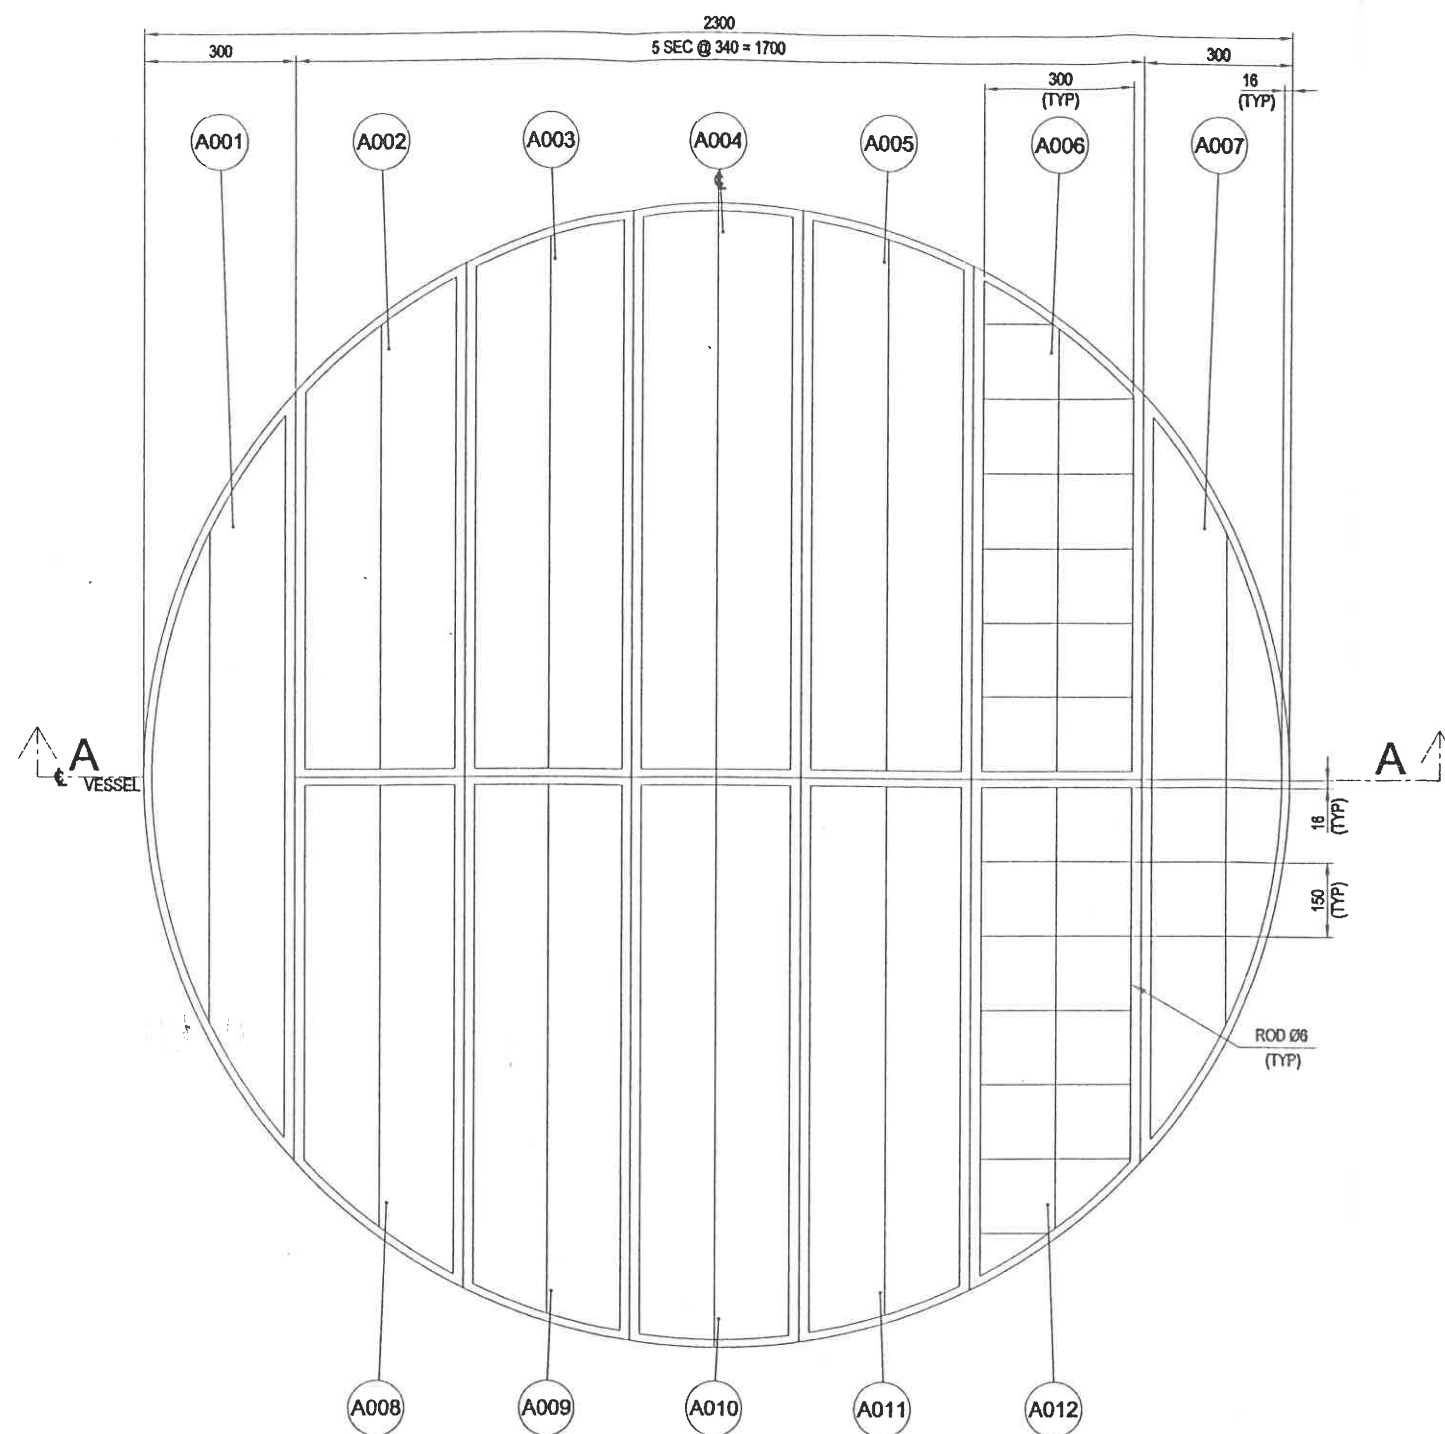


PLAN VIEW

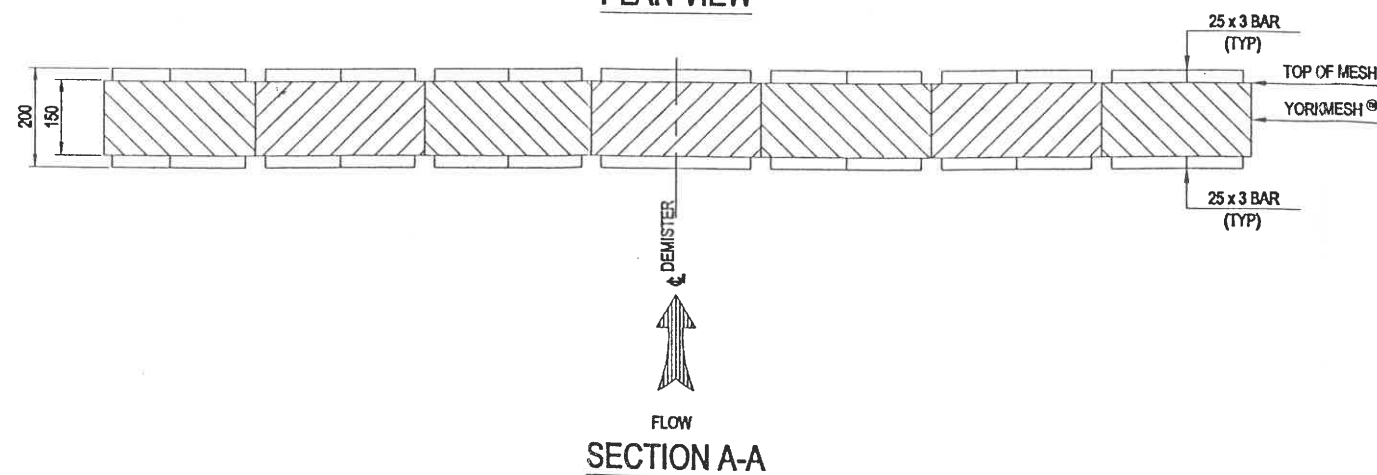

SECTION A-A

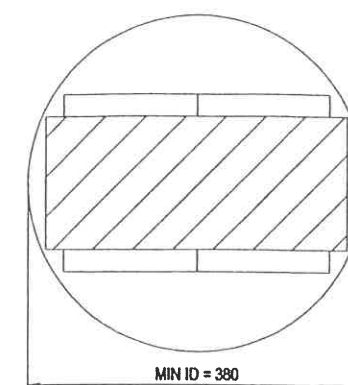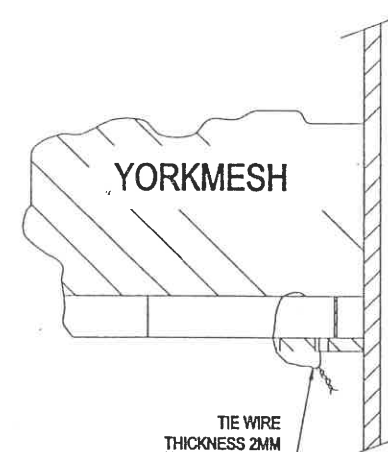MANWAY CHECK
NOT TO SCALEDET. HOLD DOWN
NOT TO SCALE

File name: 2292-081102-487723B-01.DWG

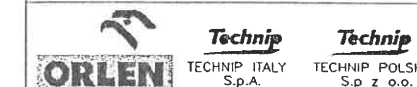

PROJ.: PARAXYLENE COMPLEX
CLIENT: PKN ORLEN S.A.

MATERIAL REQUISITION No.

2292 MR 081102

ITEM: 3-V2

SR Doc. CODE: A.1110

RIF. DATA MODIFICHE

1 14/05/08 ISSUED FOR APPROVAL

2 13/05/08 PRELIMINARY

3 13/05/08 PRELIMINARY

VENDOR DOCUMENT REVIEW

- ☐ 1 REVISE AND RESUBMIT
- ☐ 2 TO BE ISSUED AS FINAL PROVIDED COMMENTS ARE INCORPORATED
- ☒ 3 NO COMMENT - FINAL ISSUE
- ☐ 4 FOR INFORMATION ONLY (INTERNAL USE)

U.O. TECHNIP ITALY S.p.A. DATE: 13.5.08

CLIENTE: TECHNIP-ORLEN LOCALITA': POLAND DIS. CLIENTE: COMMESSA: 4877

LA TOSCANA IMPIANTI srl
57013 ROSIGNANO SOLVAY (LI)-VIA DELLA VILLANA,154
TEL.0586.790207-FAX 790588,792129

SERVICE: SEPARATOR
ITEM: 3-V2
TITLE: TRAYS AND INTERNAL SUPPORTS

CUSTOMER'S IDENTIFICATION

PURCHASED BY: LA TOSCANA
P.O. NO.: 7813
USER: - PLANT SITE: -
SPEC. NO.: - REFERENCE: -
TOWER SERVICE: - PLANT SECTION: -

K. KOCH-GLITSCH
SEPARATIONS TECHNOLOGY
© 2006 KOCH-GLITSCH, LP. ALL RIGHTS RESERVED

MODEL: DEMISTER PAD

SALES ORDER NO.: 207637

PART NO.: -

WORK ORDER NO.: 20763723A

TOWER I.D. TOWER NO.

DWG. NO.: 20763701-A

SHT. 1 OF 1 REV. 0

LA TOSCANA IMPIANTI srl
UFFICIO TECNICO

INSTALLATION DRAWING

NOTICE: KOCH-GLITSCH EQUIPMENT AND PROCESSES MAY BE COVERED BY VARIOUS UNITED STATES AND FOREIGN PATENTS AND PENDING PATENT APPLICATIONS. THIS DOCUMENT AND THE INFORMATION CONTAINED HEREIN IS THE CONFIDENTIAL AND PROPRIETARY PROPERTY OF KOCH-GLITSCH. IT IS TO BE USED FOR THE PURPOSES SPECIFICALLY STATED HEREIN AND IS NOT TO BE DISCLOSED OR PROVIDED TO ANY THIRD PARTY, OR USED, COPIED, REPRODUCED, OR TRANSMITTED IN ANY FORM OR BY ANY MEANS, WITHOUT THE PRIOR WRITTEN PERMISSION OF KOCH-GLITSCH. IN THE EVENT THAT THIS DOCUMENT OR ANY INFORMATION CONTAINED HEREIN ARE REPRODUCED OR TRANSMITTED IN ANY FORM OR BY ANY MEANS, WITHOUT THE PRIOR WRITTEN PERMISSION OF KOCH-GLITSCH, THE REPRODUCER OR TRANSMITTER WILL BE IMMEDIATELY RETURNED TO KOCH-GLITSCH AT ITS REQUEST.